
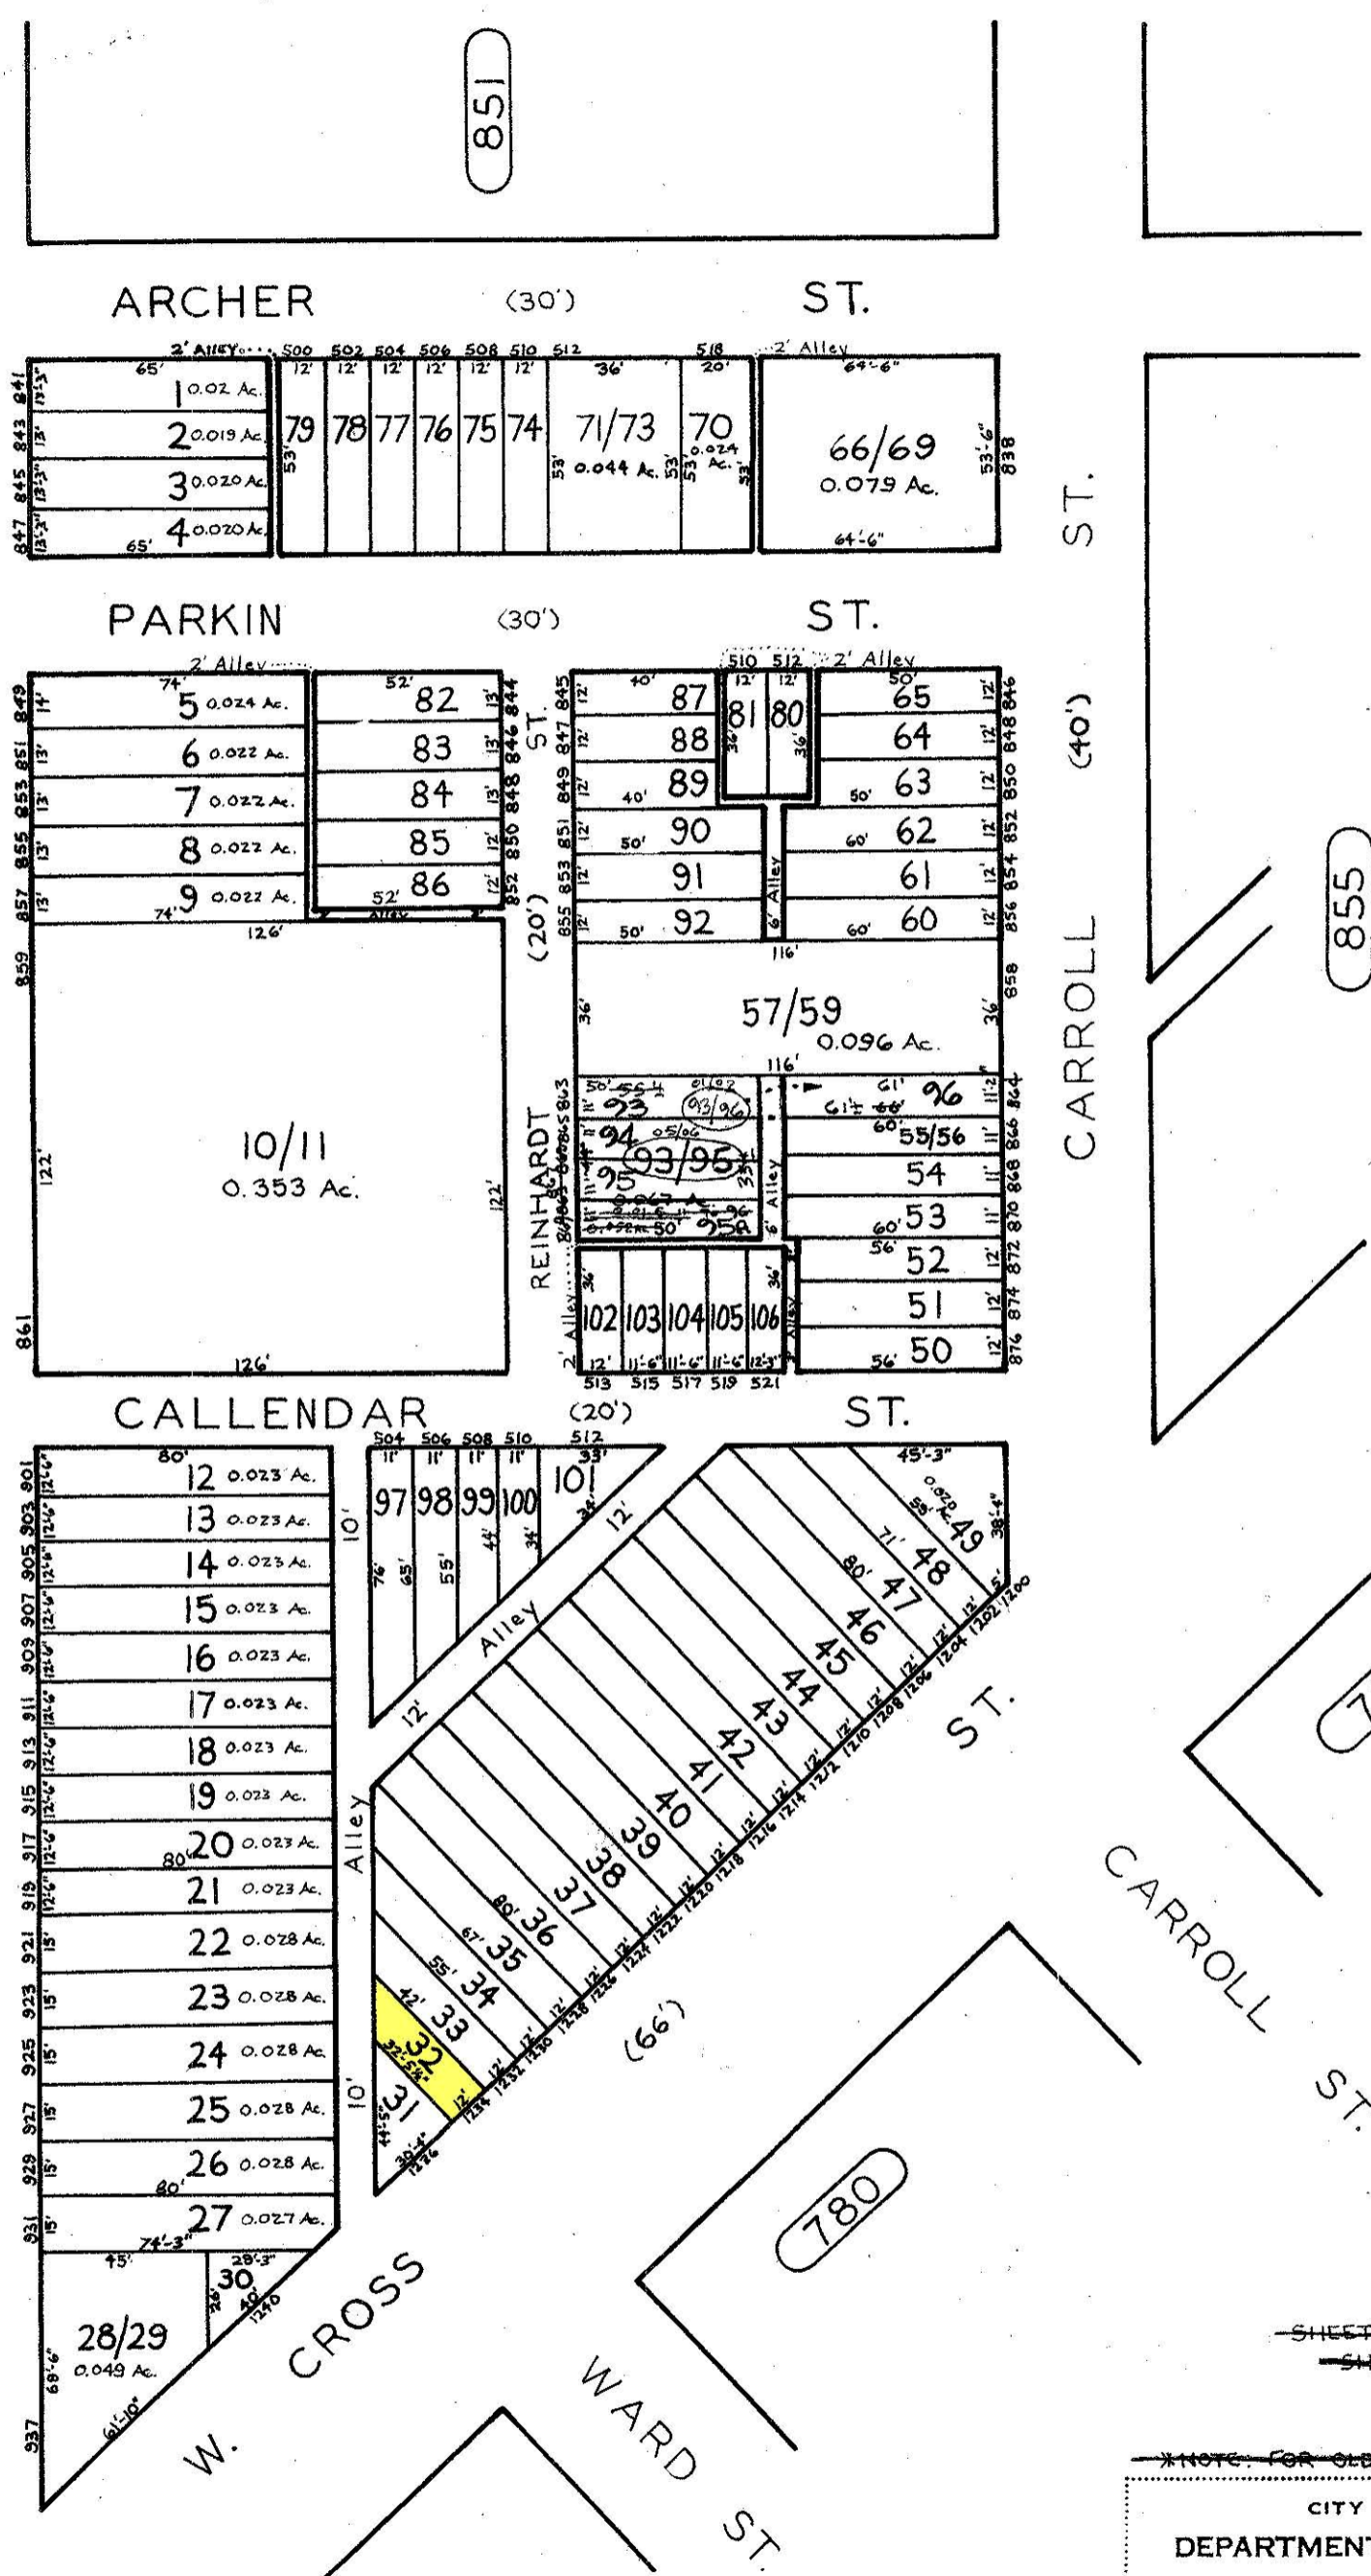


**REVISIONS**

LOT 93/96 DIV. PER DEED CH. SH. 02-202  
 LOT 93/95 DIV. PER DEED CH. SH. 06-123

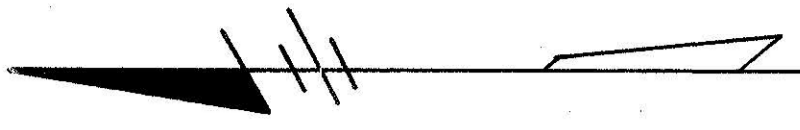

847B

847A

851

855

791

780

TRACED BY: *[Signature]*  
 LETTERED BY: *[Signature]*  
 CHECKED BY: .....

**NOTICE**  
 THIS IS A REAL PROPERTY PLAT AS PROVIDED FOR UNDER ARTICLE 76(d) OF THE CITY CHARTER IT IS COMPILED FROM TITLE AND OTHER SOURCES AND IS NOT AN AUTHENTIC SURVEY.

~~SHEETS IN SET: 2~~  
~~SHEET NO. 1~~

~~\*NOTE FOR OLD CONDITIONS SEE SHEET 2\*~~

CITY OF BALTIMORE  
 DEPARTMENT OF PUBLIC WORKS

PROPERTY LOCATION SECTION  
 WARD **21** SECTION **7**  
 BLOCK **850**  
 SCALE 1" = 50' DATE January 1997